



FLOOR 7

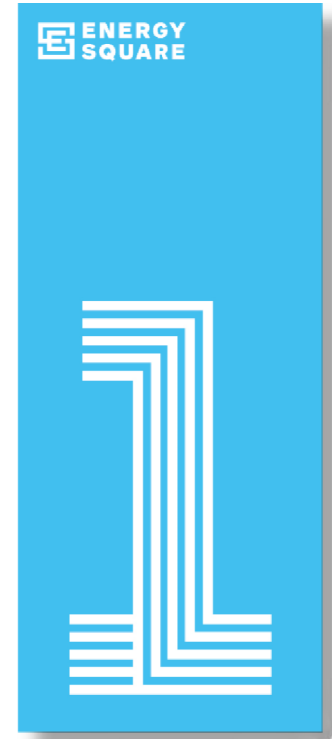

BUILDING
Energy Square 1

DETAILS
19,715 RSF

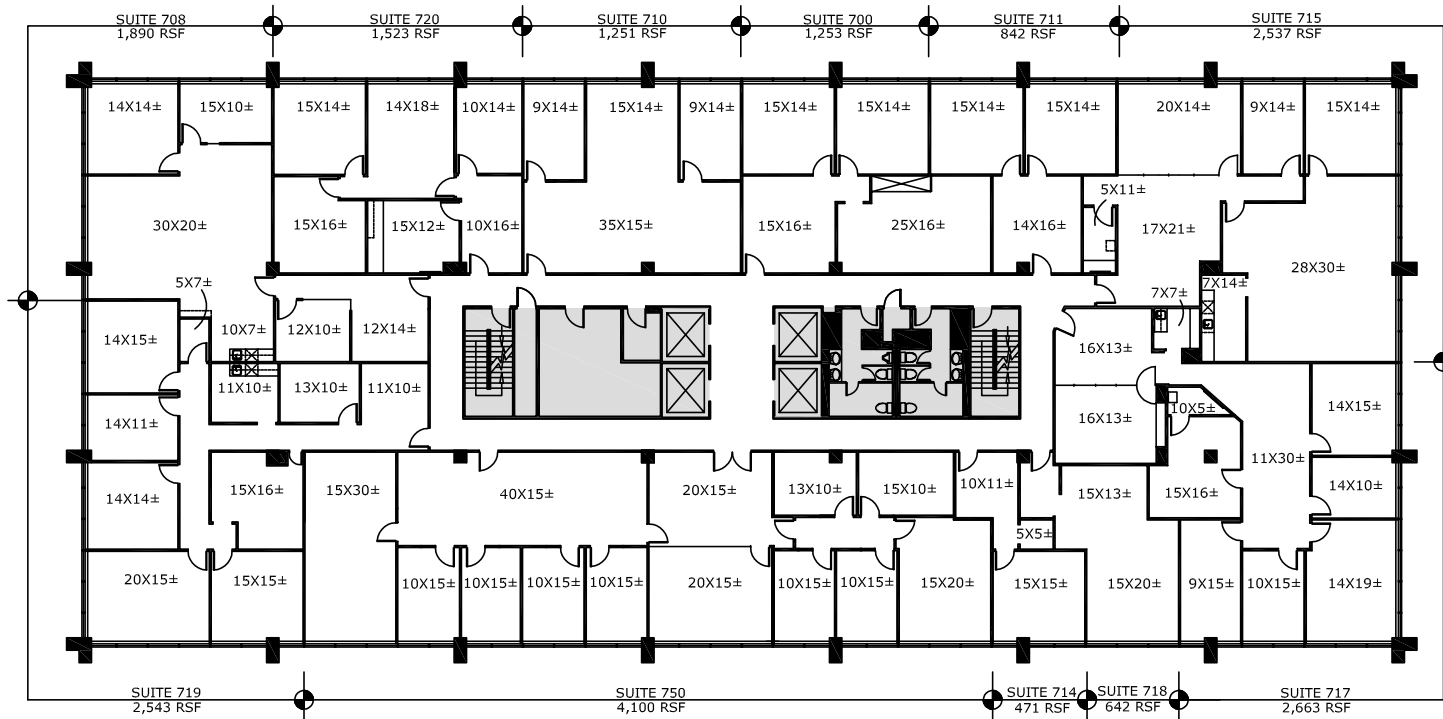